Qty:

Date: Use . Thursday, 13/11/2008 1:06:00 PM

Julie Dawson

**Process Sheet** 

Customer

: CU-DAR001 Dart Helicopters Services

Job Number

S.O. No. :

: 43418B **Estimate Number** : 10462

P.O. Number

This Issue

: 13/11/2008 : NC

Prsht Rev. First Issue

: //

: 42320B

Type

: SMALL /MED FAB

Part Number

**Drawing Name** 

: D32782

**Drawing Number** 

 D3278 REV. C : N/A

: SUPPORT

**Project Number** 

**Drawing Revision** 

Material **Due Date** 

: 28/11/2008

Each

**Checked & Approved By** 

Comment

**Previous Run** 

Written By

: Est:A 04.04.19 New issue

Est

B 07.09.06

Rev C dwg EC

Verified by: JLM

**Additional Product** 

Job Number:



Seq. #:

**Machine Or Operation:** 

Description:

1.0

6061-T6 Bar 1.00 x 2.00

Comment: Qty.:

0.2454 f(s)/Unit Total:

9.8154 f(s)

Material: 6061-T6/T651 (QQ-A-200/8) 1.00" thick

(M6061T6B1.000x02.000)

Batch: M108877 60

1107129 120

SHEAR

2.0

SHEAR

Comment: SHEAR

Cut blank: 2.00" x 1.00" x 2.550" long

3.0 HAAS1 HAAS CNC VERTICAL MACHINING #1



Comment: HAAS CNC VERTICAL MACHINING #1

- 1- Machine as per Folio FA405 and Dwg D3278
  - 2- Deburr and Tumble

Identify as D3278-2

QC2 4.0

Comment: INSPECT PARTS AS THEY COME OFF MACHINE



5.0

QC8



Comment: SECOND CHECK



## **Dart Aerospace Ltd**

W/O:			W	ORK ORDER CHAN	NGES		<del> </del>	<del></del>		<del></del>
DATE	STEP	PRO	CEDURE CH			Ву	Date	Qty	Approval Chief Eng / Prod Mgr	Approval QC Inspector
									3	
	ļ.	•								
					ļ					•
		PAR #:	Fault Cat	NCR: Yes No D			DQA: Date:			
	R	esolution:	Disposition: 0			QA: N/C Closed:			Date:	
NCR:		V	VORK ORI	DER NON-CONFOR	MANCE	(NCR)				
DATE	STEP	Description of NC	on of NC Corrective Action			ection B		ation	Approval	Approval
DAIL	J.L.	Section A	Initial Chief Eng	Action Description Chief Eng	on	Sign & Date	Section	on C	Chief Eng	QC Inspector
				•					·	
										į
								*		
				·					<u> </u>	
					Ì					

NOTE: Date & initial all entries

Thursday, 13/11/2008 1:06:00 PM Date: User: Julie Dawson **Process Sheet Drawing Name: SUPPORT** Customer: CU-DAR001 Dart Helicopters Services Part Number: D32782 Job Number: 43418B Job Number: Seq. #: Description: Machine Or Operation: HAND FINISHING RESOURCE #1 HAND FINISHING1 6.0 Comment: HAND FINISHING RESOURCE #1 Acid etch and Alodine as per QSI 005 4.1 POWDER COATING POWDER COATING 7.0 10915 **Comment: POWDER COATING** Powder Coat White Gloss (Ref: 4.3.5.1) as per QSI 005 4.3 START TIME: **OVEN TEMPERATURE:** 



FINISH TIME:

INSPECT POWDER COAT/CHEMICAL

Comment: INSPECT POWDER COAT PACKAGING RESOURCE #1 PACKAGING 1

08

Comment: PACKAGING RESOURCE #1 Identify and Stock Location:

Comment: FINAL INSPECTION/W/O RELEASE

Job Completion

8.0

9.0

10.0

QC3

QC21



N/O:			WORK ORDER CHANGES							
DATE	STEP	PR	OCEDURE CHANGE	Ву		By Date	Qty	Approval Chief Eng / Prod Mgr	Approval QC Inspector	
									1	
Part No	:	PAR #:	Fault Category:	NCR:	Yes	No <b>DQ</b>	A:	_ Date: _		
	Resolution:		Disposition:	QA: N	/C CI	osed:		Date:		

NCR:		WORK ORDER NON-CONFORMANCE (NCR)										
		Description of NC		Corrective Action Section B		Verification	A	Approval				
DATE	STEP	Section A			Sign & Date	Section C	Approval Chief Eng	QC Inspector				
			1 to									
						;						
		·	[									
		•										

NOTE: Date & initial all entries

DART AEROSPACE LTD	Work Order:	341813	
Description: Support		Part Number:	D3278-2
Inspection Dwg: D3278 Rev: C			Page 1 of 1

#### FIRST ARTICLE INSPECTION CHECKLIST

X First Article Prototype

Drawing Dimension	Tolerance	Actual Dimension	Accept	Reject	Method of Inspection	Comments
Ø0.098	+0.005/-0.000	\$ 0.100	<b>V</b>	,,	·	
0.359	+/-0.005,	0.361	/			
0.609	+/-0.010	0.614		-		, ,
0.250	+/-0.010	0.251	<b>/</b>			
1.480	+/-0.005	1.480	<b>/</b>			
R0.125	+/-0.010	R O. 125	<b>V</b>			
0.119	+0.005/-0.004	0.120	<b>✓</b>			
2.439	+/-0.010	2.440	V	,		
1.980	+/-0.010	1.981	<b>✓</b>		·	
R0.13	+/-0.030	RO.13	/			
Ø0.257	+0.005/-0.000	Ø 0.260	/			
R0.375	+/-0.010	R 0.375	/			
0.875	+/-0.010	0.873	<b>V</b>			
0.500	+/-0.010	0.500	V.			
R0.400	+/-0.010	R 0.400	>	-		
R1.00	+/-0.030	R1.00	~			
1.720	+/-0.010	1.721	<b>✓</b>			
R0.125	+/-0.010	RO. 125	<b>V</b>			
0.125	+/-0.010	0.126	~			

Measured by: BA	Audited by: J.)_	Prototype Approval:	N/A
Date: 07/11/19	Date: 08   11   21	Date:	N/A


A 04.04.19 New Issue P/O D3278-041 KJ/JLM	
A. 04.04.19   New 133de   1/0 D0210 041	
B 05.06.08 0.359 was 0.365; 0.119 was 0.125 KJ/JLM	
C 07.09.26 Dimensions updated per Dwg Rev. C KJ/EC	de E



	DESIG	9	DRAWN BY	DART AEROSPACE HAWKESBURY, ONTARIO, CANADA		
	CHEC	KED 12	APPROVED	DRAWING NO.		REV. C
i		-43	#	D3278	SHEET	1 OF 3
	DATE			TITLE		SCALE
	07.0	7.24		SUPPORT ASSEMBLY		NTS
	Α		04.03.03	NEW ISSUE		
	В		05.03.31	CHANGE DIM/TOL TO ENSURE	FIT	
	С		07.07.24	CHANGED RIVETS PER PAR #18	85	

## DELEASED 107 vs. 45-1

## D3278-041 SUPPORT ASSEMBLY

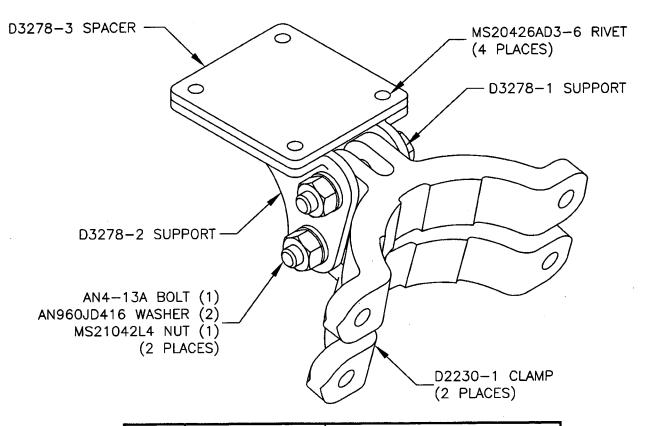

	Description	Part Number	Qty
	SUPPORT ASSEMBLY	D3278-041	Х
	CLAMP	D2230-1	2
	SUPPORT	D3278-1	1
	SUPPORT	D3278-2	1
	SPACER	D3278-3	1
UNG			
SU	BOLT	AN4-13A	2
	WASHER	AN960JD416	4
	RIVET	MS20426AD3-6	4
N	NUT	MS21042L4	2


SHOP COPY
RETURN TO
ENGINEERING
ONTROLLED COPY
JECT TO AMENDMENT
WITHOUT NOTICE


Copyright @ 2004 by DART AEROSPACE LTD

THIS DOCUMENT IS PRIVATE AND CONFIDENTIAL AND IS SUPPLIED ON THE EXPRESS CONDITION THAT IT IS NOT TO BE USED FOR ANY PURPOSE OR COPIED OR COMMUNICATED TO ANY OTHER PERSON WITHOUT WRITTEN PERMISSION FROM DART AEROSPACE LTD.



DESIGN	DRAWN BY	DART AEROSP, HAWKESBURY, ONTARIO	
CHECKED	APPROVED,	DRAWING NO.	REV. C
<del>-</del> #	-H	D3278	SHEET 2 OF 3
DATE		TITLE	SCALE
07.07.24	•	SUPPORT ASSEMBLY	1:1

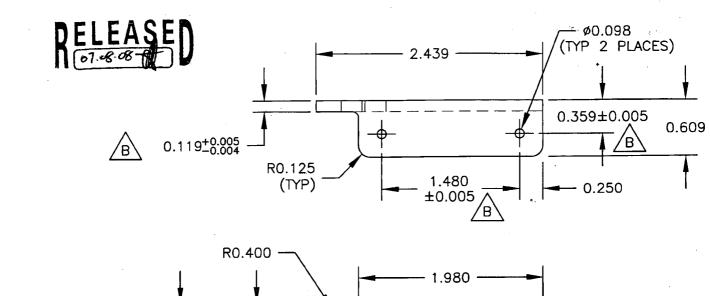

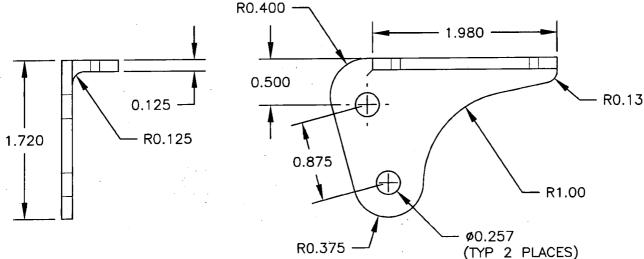

# D3278-1 SUPPORT (SHOWN) D3278-2 SUPPORT (OPPOSITE)

1) MACHINE PER DWG FILE "D3278-1.SLDPRT"

2) MATERIAL: 6061-T6 (OR 6061-T651/T6510/T6511/T62) BAR

PER AMS-QQ-A-225/8 (OR AMS 4117/4128/4115/4116)

PER AMS-QQ-A-200/8 (OR AMS 4160)

(REF. DART SPEC. M6061T6B)

3) FINISH: CHEMICAL CONVERSION COAT PER DART QSI 005 4.1 POWDER COAT WHITE (4.3.5.1) PER DART QSI 005 4.3

4) BREAK ALL SHARP EDGES 0.005 TO 0.015

5) TOLERANCES ARE PER DART QSI 018 UNLESS OTHERWISE NOTED

6) ALL DIMENSIONS ARE IN INCHES UNLESS OTHERWISE NOTED

SHOP COPY
RETURN TO
ENGINEERING
UNCONTROLLED COP
SUBJECT TO AMENDMENT
WITHOUT NOTICE

NO. 43428B


Copyright © 2004 by DART AEROSPACE LTD

THIS DOCUMENT IS PRIVATE AND CONFIDENTIAL AND IS SUPPLIED ON THE EXPRESS CONDITION THAT IT IS NOT TO BE USED FOR ANY PURPOSE OR COPIED OR COMMUNICATED TO ANY OTHER PERSON WITHOUT WRITTEN PERMISSION FROM DART AEROSPACE LTD.



DESIGN	DRAWN BY	DART AEROS HAWKESBURY, ONT	
CHECKED	APPROVED	DRAWING NO. D3278	REV. C SHEET 3 OF 3
DATE		TITLE	SCALE
07.07.24		SUPPORT ASSEMBLY	1:1



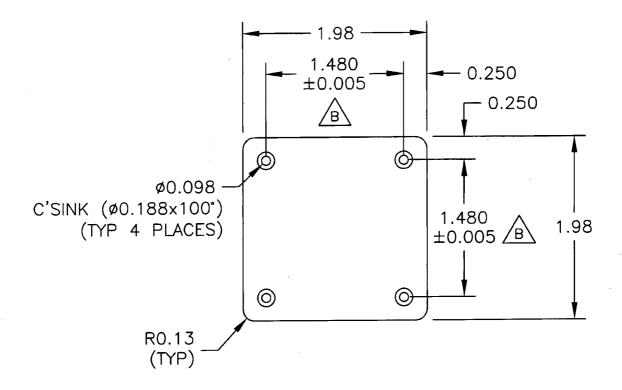

### **D3278-3 SPACER**

1) MATERIAL: DELRIN II 150E OR ACETRON GP ACETAL

(REF. DART SPEC. M-DELRIN-B0.125×2.000) OR

DELRIN II 150E OR ACETRON GP ACETAL

(REF. DART SPEC. M-DELRIN-S.125)

- 2) BREAK ALL SHARP EDGES 0.005 TO 0.015
- 3) TOLERANCES ARE PER DART QSI 018 UNLESS OTHERWISE NOTED
- 4) ALL DIMENSIONS ARE IN INCHES UNLESS OTHERWISE NOTED

SHOP COPY
RETURN TO
ENGINEERING
UNCONTROLLED COPY
SUBJECT TO AMENDMENT
WITHOUT NOTICE
WORK ORDERO

NO 43978B

Copyright © 2004 by DART AEROSPACE LTD

THIS DOCUMENT IS PRIVATE AND CONFIDENTIAL AND IS SUPPLIED ON THE EXPRESS CONDITION THAT IT IS NOT TO BE USED FOR ANY PURPOSE OR COPIED OR COMMUNICATED TO ANY OTHER PERSON WITHOUT WRITTEN PERMISSION FROM DART AEROSPACE LTD.

	مستنشب والمستناء	· ·		•	•						
		<del></del>				•					
		<b>X</b> (1)	*4* *				•			·	
*		,		•							
•	~				•					•	
	Notice of the second									•	
								. •			
							• `				,
		1									
aV				•							
:				•							
			And and					·			
									,		
·									٠		
		•	-								
	A. Carrie		•								• \$
•											·
											,
•											
											t sa
											•
							•	,			
	•						* · · · · · · · · · · · · · · · · · · ·	•		,	
							*				•
•	•										MA.
•		<b>\</b>									
	\$20 THE STATE OF STAT				27						
			tri <b>ac</b>								
• • •				,	•						
•							<del>*</del> . *				•
		* ·		÷.			•				
				<del>,</del>							
	*										·
, ,		v									
		· .									•
				<b>≱</b> 4 22 - 23 - 34							♥
			. i						•		